



Cape St Francis Extension No. 3
GENERAL PLAN TP 9574

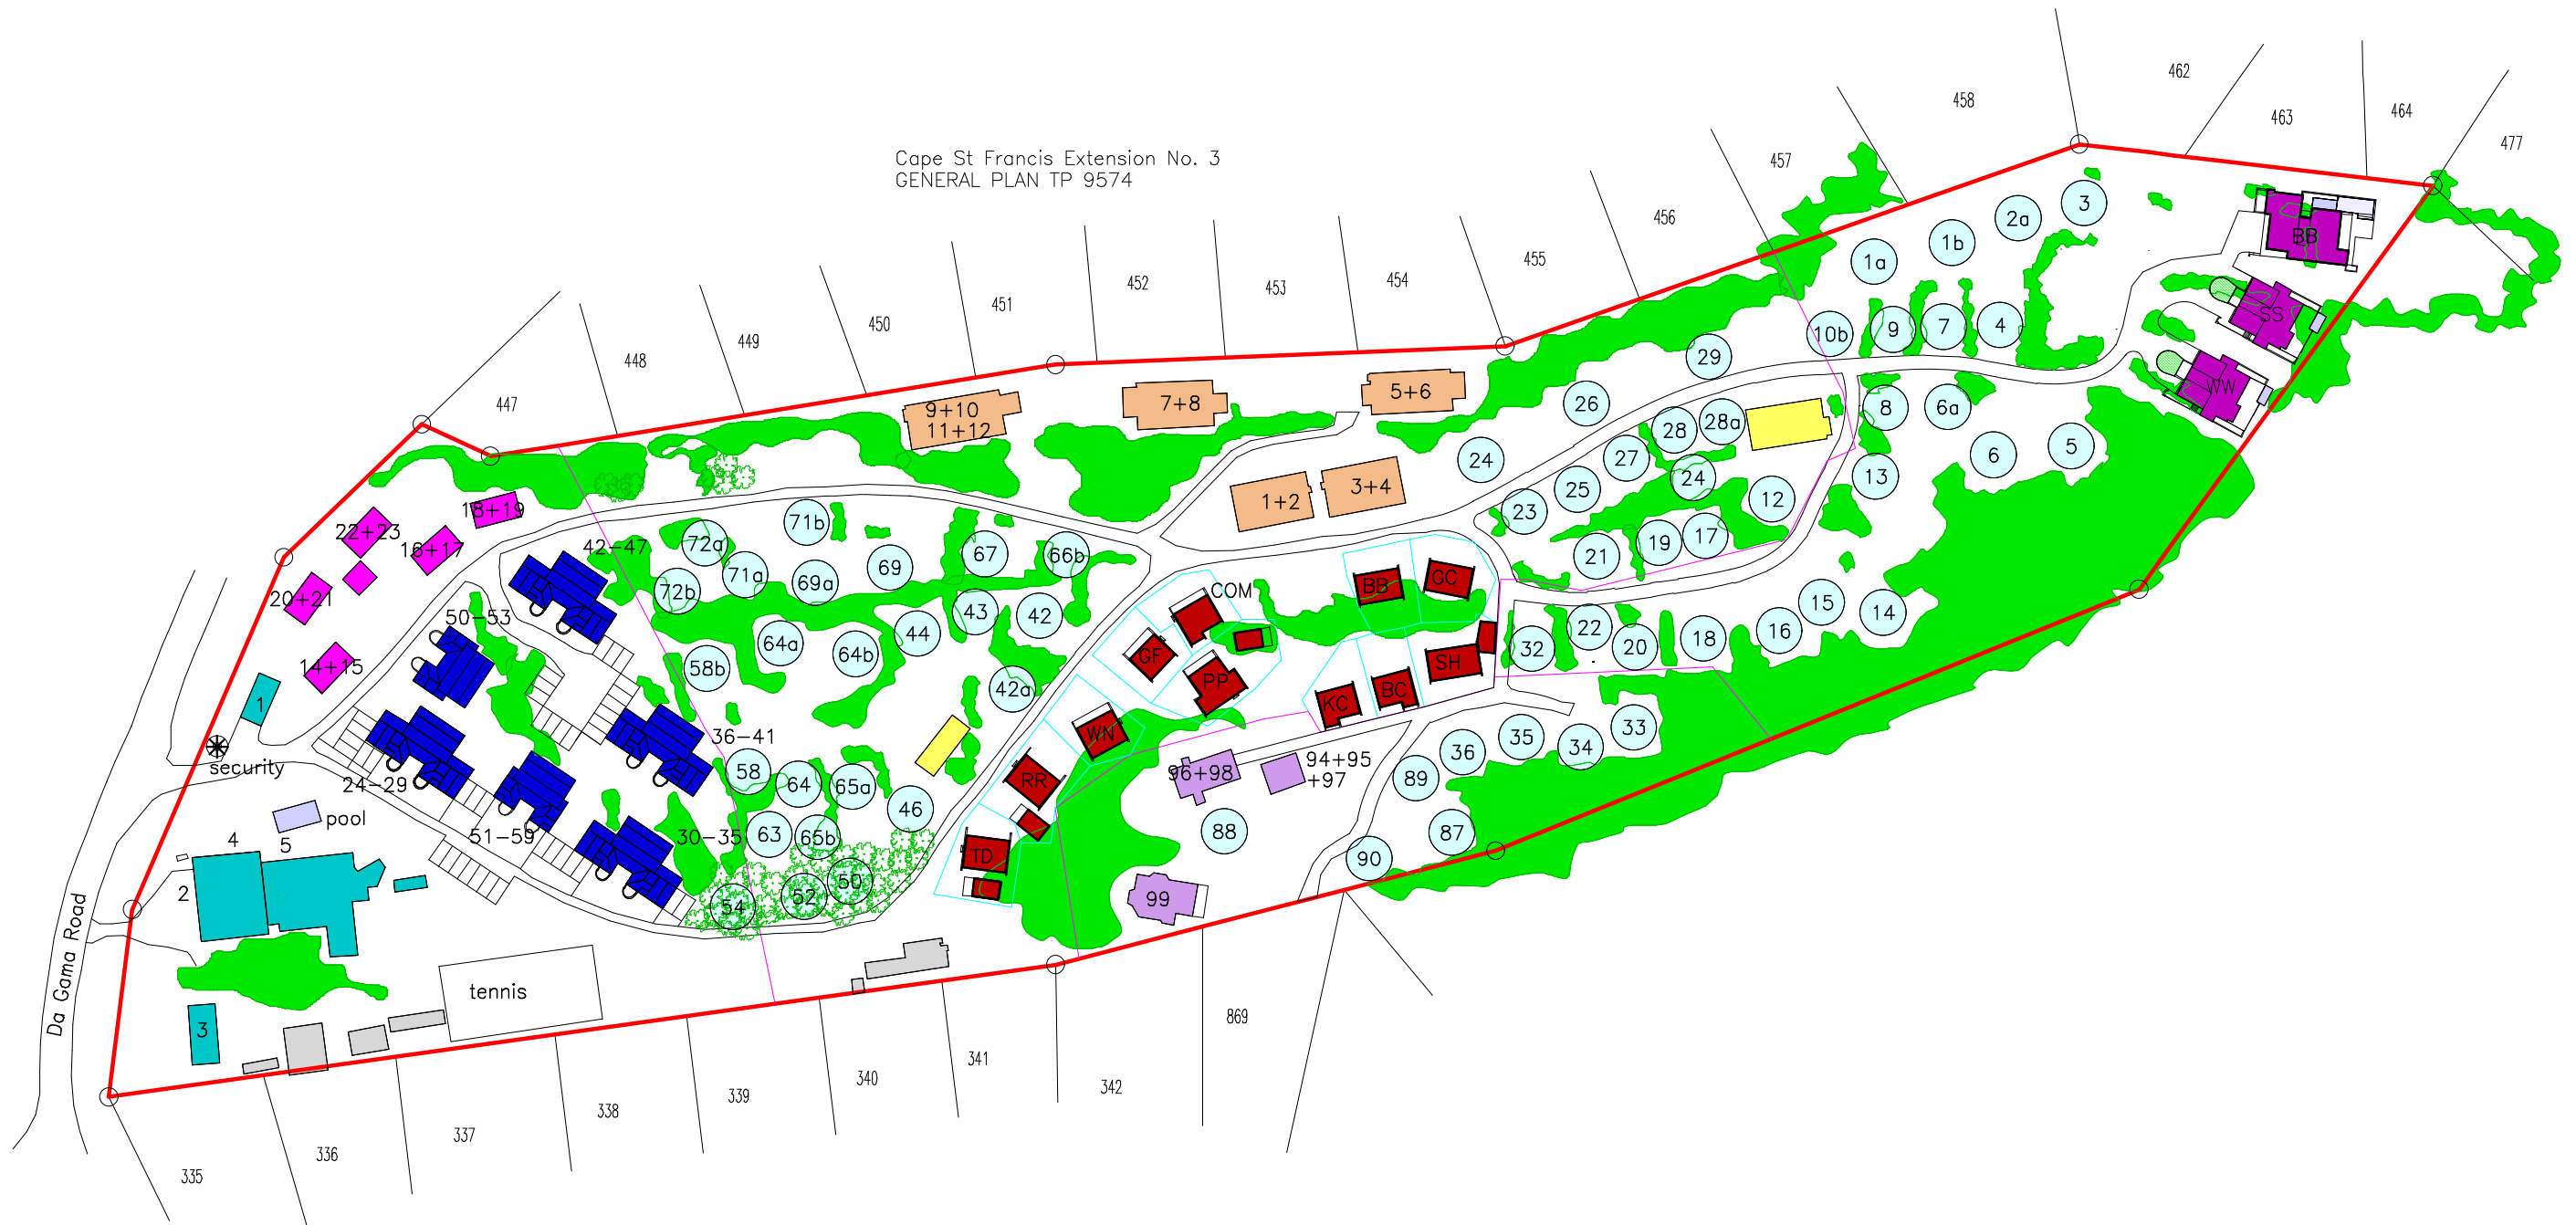

ADMINISTRATION	BACKPACKERS	THE CLUB	THE VILLAGE	KLIP COMPLEX	HILLSIDE	BEACH UNITS	ABLUTIONS
1 RECEPTION 2 CONFERENCES 3 WORKSHOP 4 SHOP 5 RESTAURANT+PUB	unit 14+15 unit 16+17 unit 18+19 unit 20+21 unit 22+23	unit 24 - 29 unit 30 - 35 unit 36 - 41 unit 42 - 47 unit 50 to 53 unit 54 - 59	TD TURTLE DOVE RR ROBINS REST WN WEAVERS NEST GN GUINEA FOWL COM CORMORANT COTTAGE BB BULBUL BUNGALOW GC GANNET COTTAGE SN SWALLOWS NEST BC BOKMAKERIE COTTAGE KC KINGFISHER CLOSE PP PLOVER PLACE	94 AGTERKLIP 95 ONDERKLIP 96 KLEINKLIP 97 KLIPPIE 98 POOL HOUSE 99 HUISKLIP	1 SEALS 2 BRUCES 3 HULETTS 4 SIXTY NINES 5 2ND BUSH 6 SHARK POINT 7 ANGELS 8 SHELLEY BEACH 9 OSPREY 10 GENESIS 11 LYNGENFJORD 12 PANAGHIA	BB BEACH BREAK SS SEAGULLS SONG WW WAVE WARRIOR	88 CAMP SITES numbered 1 - 90

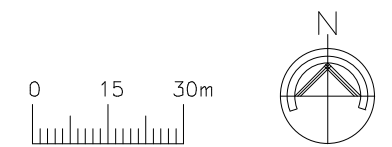

MASTERPLAN 1:1500

CAPE ST FRANCIS RESORT

Portions A-G of ERF 862 + REM of ERF 831 Cape St Francis

AS BUILT MP